



PARTIAL FLOOR 29

5,020 SF



OPEN WORK



PRIVATE OFFICE


AVAILABILITY

- Prebuilt Space
- Corner Unit
- East River Views
- Arranged Possession

PROPERTY FEATURES

- Building-wide window and perimeter induction unit replacement program completed in 2019
- Green roofs and exclusive outdoor terraces
- Outdoor plaza featuring a zinc green wall
- Renovated lobby
- LEED Gold certified under LEED v4 Existing Buildings: Operations + Maintenance

AS-BUILT PLAN

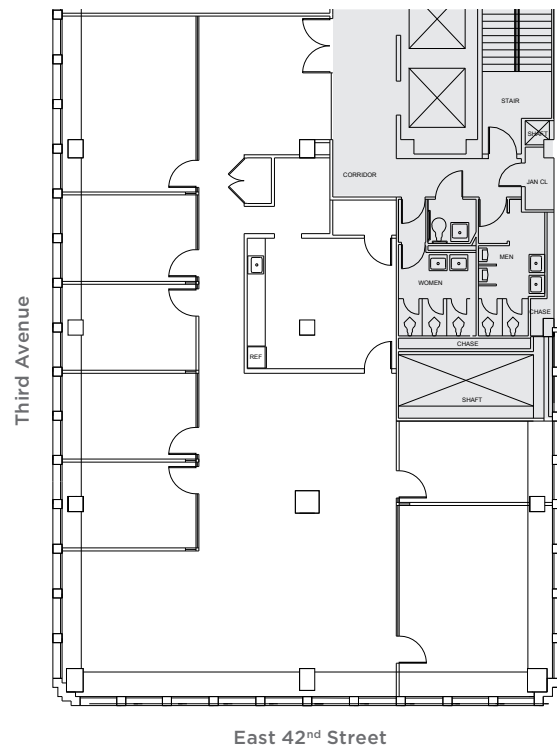

LEASING CONTACTS

Ashlea Aaron
212.257.6590
AAaron@durst.org

Bailey Caliban
212.257.6535
BCaliban@durst.org