

655 THIRD AVENUE

PARTIAL FLOOR 9
13,069 SF



BUILDING EXTERIOR



BUILDING LOBBY

AVAILABILITY


- Office Intensive Built Space
- Midtown, 42nd Street, and East River Views
- Second Generation
- Divisions Considered
- Arranged Possession

PROPERTY FEATURES

- One block from Grand Central Terminal
- Renovated lobby includes a new concierge desk and turnstiles
- Green roofs and exclusive outdoor terraces
- LEED Gold certification under LEED v4 Existing Buildings: Operations + Maintenance

AS-BUILT PLAN

East 42nd Street

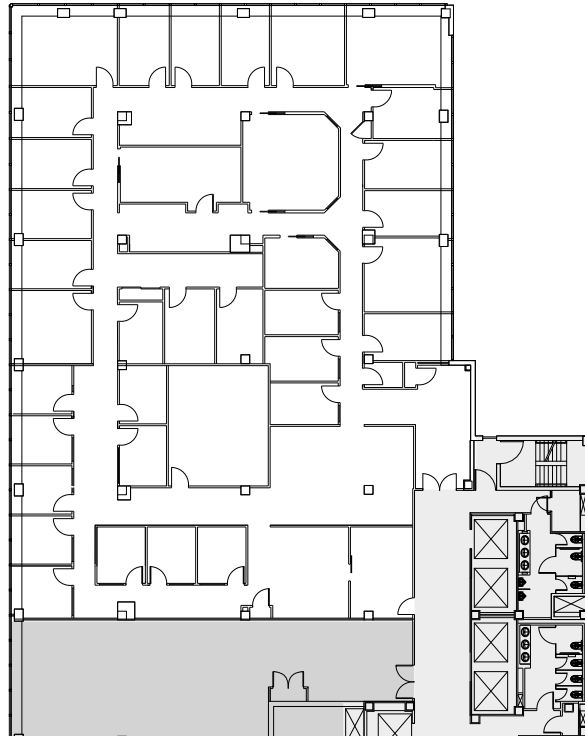

East 41st Street



LEASING CONTACTS

Ashlea Aaron
212.257.6590
AAaron@durst.org

Bailey Caliban
212.257.6535
BCaliban@durst.org