

220 FRONT STREET

GROUND FLOOR RETAIL 800 SF



STOREFRONT



TURKEY BAR INSTALLATION

AVAILABILITY


- Alternate Dry Good Uses Considered
- All Glass Storefront
- Four Steps Above Grade
- Interior Accentuated with Historical Detailing and Materials
- 25' of Frontage
- 16' Ceilings

PROPERTY FEATURES

- Historic Front Street comprises eleven restored 18th century buildings and three new construction buildings with 95 residential and 15 commercial units.
- The surrounding restaurants, bars, shops, and museums of the Seaport District — as well as the newly activated Pier 17 and proximity to the Brooklyn Bridge — provide year-round foot traffic.
- Actively developing residential, commercial, and retail neighborhood with 938 residential units and 230k SF of office currently under construction.

AS-BUILT PLAN

Front Street

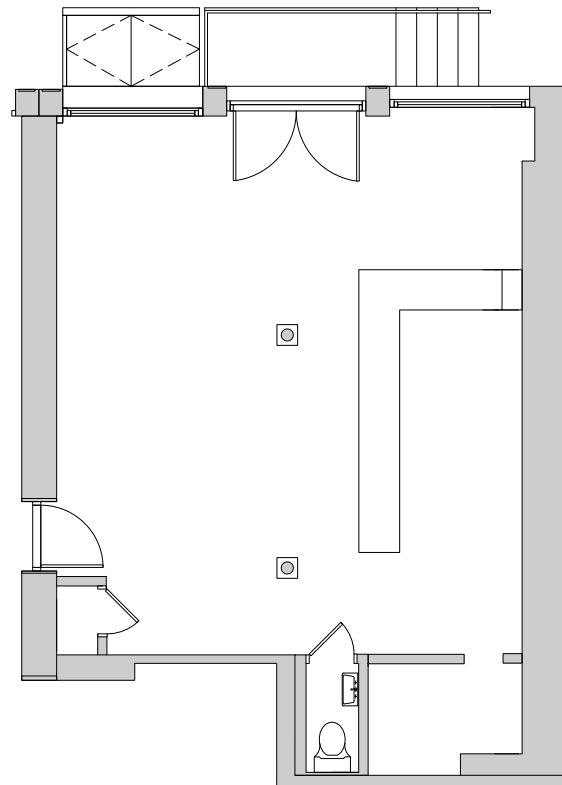

DURST LEASING CONTACTS

Karen Rose
212.667.8705
KRose@durst.org



KSR LEASING CONTACTS

Zach Nathan
240.731.8333
znathan@ksrny.com

Brandon Berger
646.236.8525
bberger@ksrny.com

Hunter Lazan
772.559.5195
hlazan@ksrny.com