

# 1155

AVENUE OF THE AMERICAS

A VIEW FOR EVERY VISION

## ENTIRE FLOOR 26

16,563 SF



LOBBY



PLAZA & ENTRANCE


### AVAILABILITY

- Built Space
- Office Intensive Layout
- Available October 2026

### PROPERTY FEATURES

- New Landscaped Plaza, Building Entrance, and Lobby
- Elevator Modernization Including Destination Dispatch Controls
- New Energy-Efficient Curtain Wall With Floor-to-Ceiling Clear Glazing at Chamfered Corners
- New Low-Iron Energy-Efficient Casement Windows
- Certified LEED Gold Under LEED v4 Existing Buildings: Operations + Maintenance
- Located at the Convergence of Bryant Park and Corporate Row — Mere Minutes From Grand Central Terminal, 16 Subway Lines, and Some of NYC's Best Dining and Entertainment

### AS-BUILT PLAN

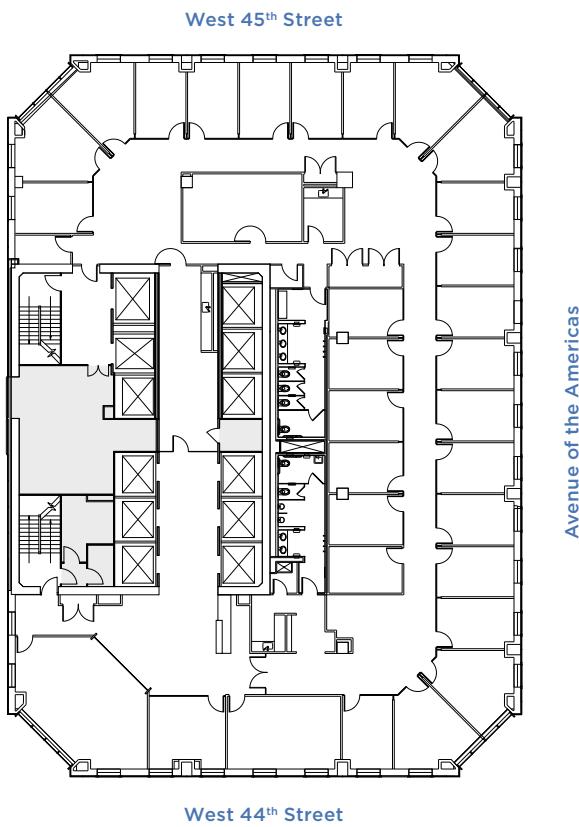

#### LEASING CONTACTS

**Rocco Romeo**  
212.257.6630  
RRomeo@durst.org

**Nora Caliban**  
212.789.6029  
NCaliban@durst.org

**Thomas Bow**  
212.257.6610  
TBow@durst.org

1155AoA.com