

11 GRAND CENTRAL EAST

ENTIRE FLOOR 23 7,442 SF



BUILDING EXTERIOR



BUILDING LOBBY



TERRACE


AVAILABILITY

- Built Space
- Contiguous Block of Up to 15k SF Available
- Arranged Possession

PROPERTY FEATURES

- New windows and perimeter induction units promote tenant comfort and energy efficiency
- Select floors feature green roofs and private terraces
- LEED GOLD Certification under LEEDv4 Existing Building: Operations and Maintenance
- Block and a half from Grand Central Terminal

AS-BUILT PLAN

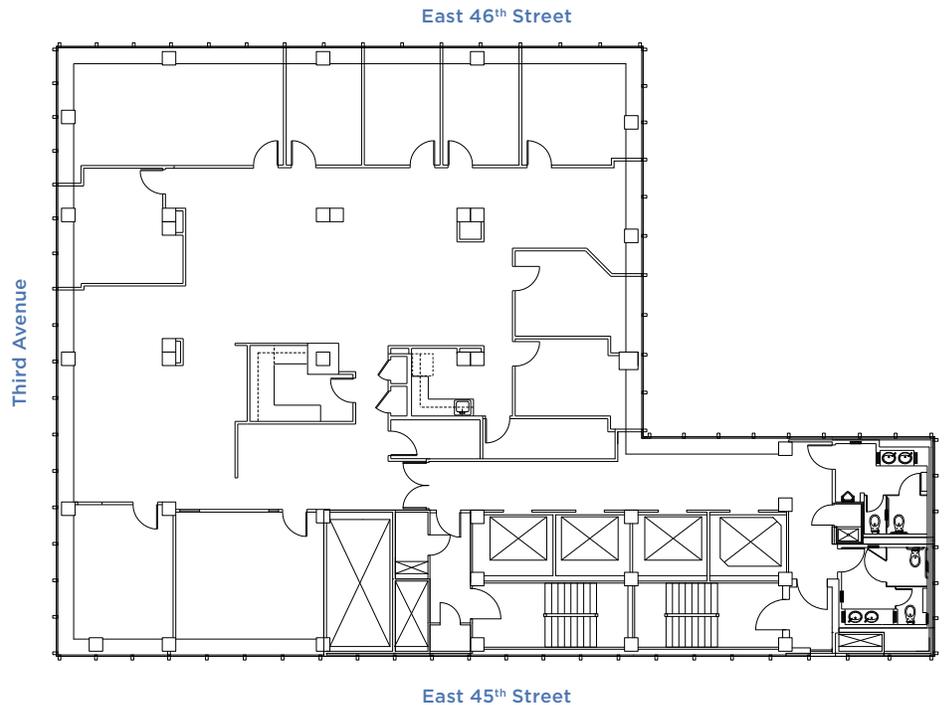

LEASING CONTACTS

Karen Rose
212.257.6596
KRose@durst.org

Bailey Caliban
212.257.6535
BCaliban@durst.org

Sayo Kamara
212.789.1761
SKamara@durst.org

Eric Engelhardt
212.257.6620
EEngelhardt@durst.org