

ONE FIVE ONE

151 WEST 42 ST

PARTIAL FLOOR 3

24,336 SF



42ND STREET LOBBY



WELL& AMENITY FLOOR

AVAILABILITY


- Completed Whitebox
- Bryant Park & 42nd Street Views
- 20' Slab-to-Slab Height

PROPERTY FEATURES

- Future-focused workspaces boast dramatic views, ample natural light, inspiring outdoor terraces, generous ceiling heights, and expansive column-friendly floor plates steps from Bryant Park
- 45,600-SF Well& by Durst amenity floor blends an artisanal food hall, cocktail bar, event space, and boutique meeting venues
- \$150 million capital improvement program introduced a new lobby and entrances, elevators with destination dispatch, state-of-the-art MEP upgrades, and energy efficient enhancements
- LEED Gold certification under LEED v4 Existing Buildings: Operations + Maintenance
- Awarded SAFETY Act Designation by the Department of Homeland Security

AS-BUILT PLAN

West 43rd Street

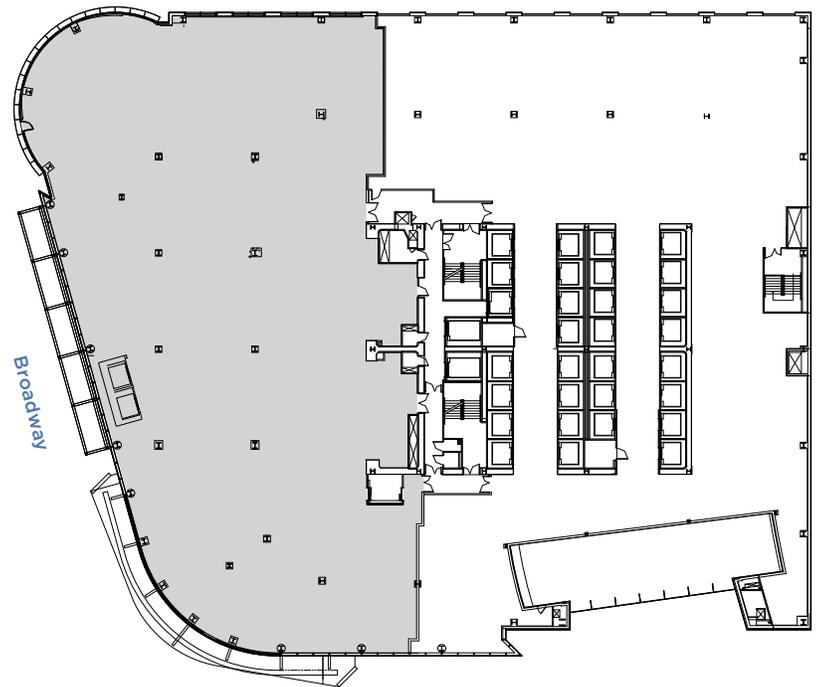

West 42nd Street



LEASING CONTACTS

Rocco Romeo
212.257.6630
RRomeo@durst.org

Nora Caliban
212.789.6029
NCaliban@durst.org

Thomas Bow
212.257.6610
TBow@durst.org