



NYC'S LARGEST
TAMI TENANT COMMUNITY

2,556 SF PARTIAL FLOOR 46 - SUITE C



LOBBY



EXTERIOR



WELL& BY DURST AMENITY SPACE

AVAILABILITY FEATURES

- Built Space
- Arranged Possession

PROPERTY FEATURES


- Home to a diverse group of industry-types including NYC's largest TAMI (technology, advertising, media, information) tenant community, One World Trade Center's state-of-the-art architectural, environmental, and structural design combines with unmatched convenience, ample amenities, and a vibrant neighborhood to inspire innovation, productivity, and success.
- Direct access to 11 subway lines, the PATH, two ferry terminals, numerous bus routes, and five Citi Bike stations.
- Located in the heart of Lower Manhattan's vibrant retail, dining, and cultural hub.

CURRENT PLAN DETAILS

Private Offices	4
Conference Room	1
Reception	1
Pantry	1

AS-BUILT PLAN

View of Midtown Manhattan

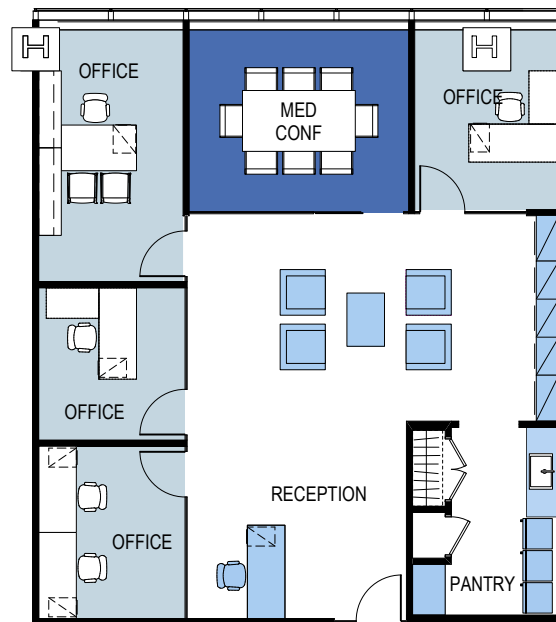

[CLICK HERE FOR ALL ONE WORLD TRADE CENTER AVAILABILITIES](#)



Eric Engelhardt 212.667.8704 EEngelhardt@durst.org	Karen Rose 212.667.8705 KRose@durst.org	Sayo Kamara 212.789.1761 SKamara@durst.org	David Falk 212.372.2271 David.Falk@nmrk.com	Peter Shimkin 212.372.2150 Peter.Shimkin@nmrk.com	Hal Stein 212.233.8185 Hal.Stein@nmrk.com	Nathan Kropp 212.372.2056 Nathan.Kropp@nmrk.com	Paige Raisides 212.655.1227 Paige.Raisides@nmrk.com
---	--	---	--	--	--	--	--