

227 FRONT STREET

TURNKEY RESTAURANT OPPORTUNITY 2,824 SF



ENCLOSED PATIO*



BAR/DINING*

AVAILABILITY


- Fully Built, Double Storefront Restaurant
- Dining, Private Dining, Enclosed Patio, and Two Bar Spaces
- Substantially Equipped Commercial Kitchen
- 52' of Frontage

PROPERTY FEATURES

- Historic Front Street comprises eleven restored 18th century buildings and three new construction buildings with 95 residential and 15 commercial units.
- The surrounding restaurants, bars, shops, and museums of the Seaport District — as well as the newly activated Pier 17 and proximity to the Brooklyn Bridge — provide year-round foot traffic.
- Actively developing residential, commercial, and retail neighborhood with 938 residential units and 230k SF of office currently under construction.

AS-BUILT PLAN

Front Street

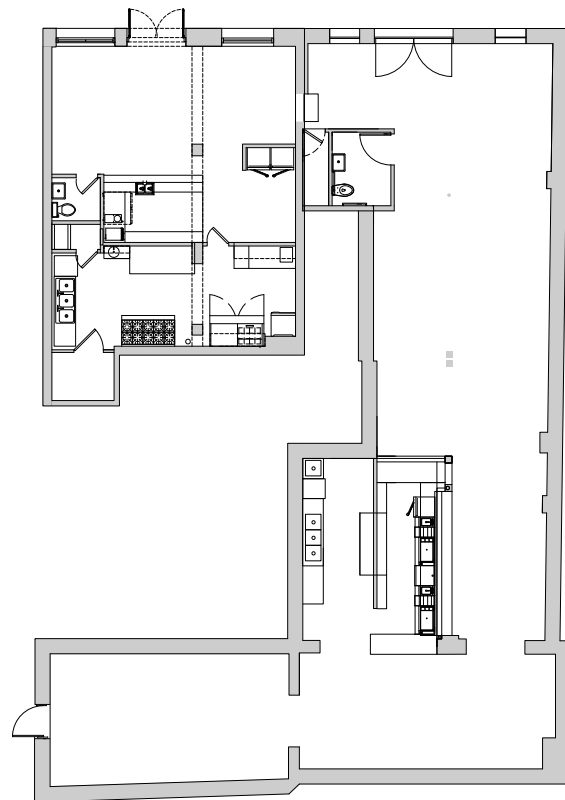

KSR LEASING CONTACTS



Zachary Nathan
240.731.8333
znathan@ksrny.com

Hunter Lazan
772.559.5195
hlazan@ksrny.com

Hilla Benshoshan
215.500.5682
hbenshoshan@ksrny.com

Brandon Berger
646.236.8525
bberger@ksrny.com



DURST LEASING CONTACT

Karen Rose
212.667.8705
KRose@durst.org